




# 福岡市寺塚土地区画整理事業換地図

单位：m

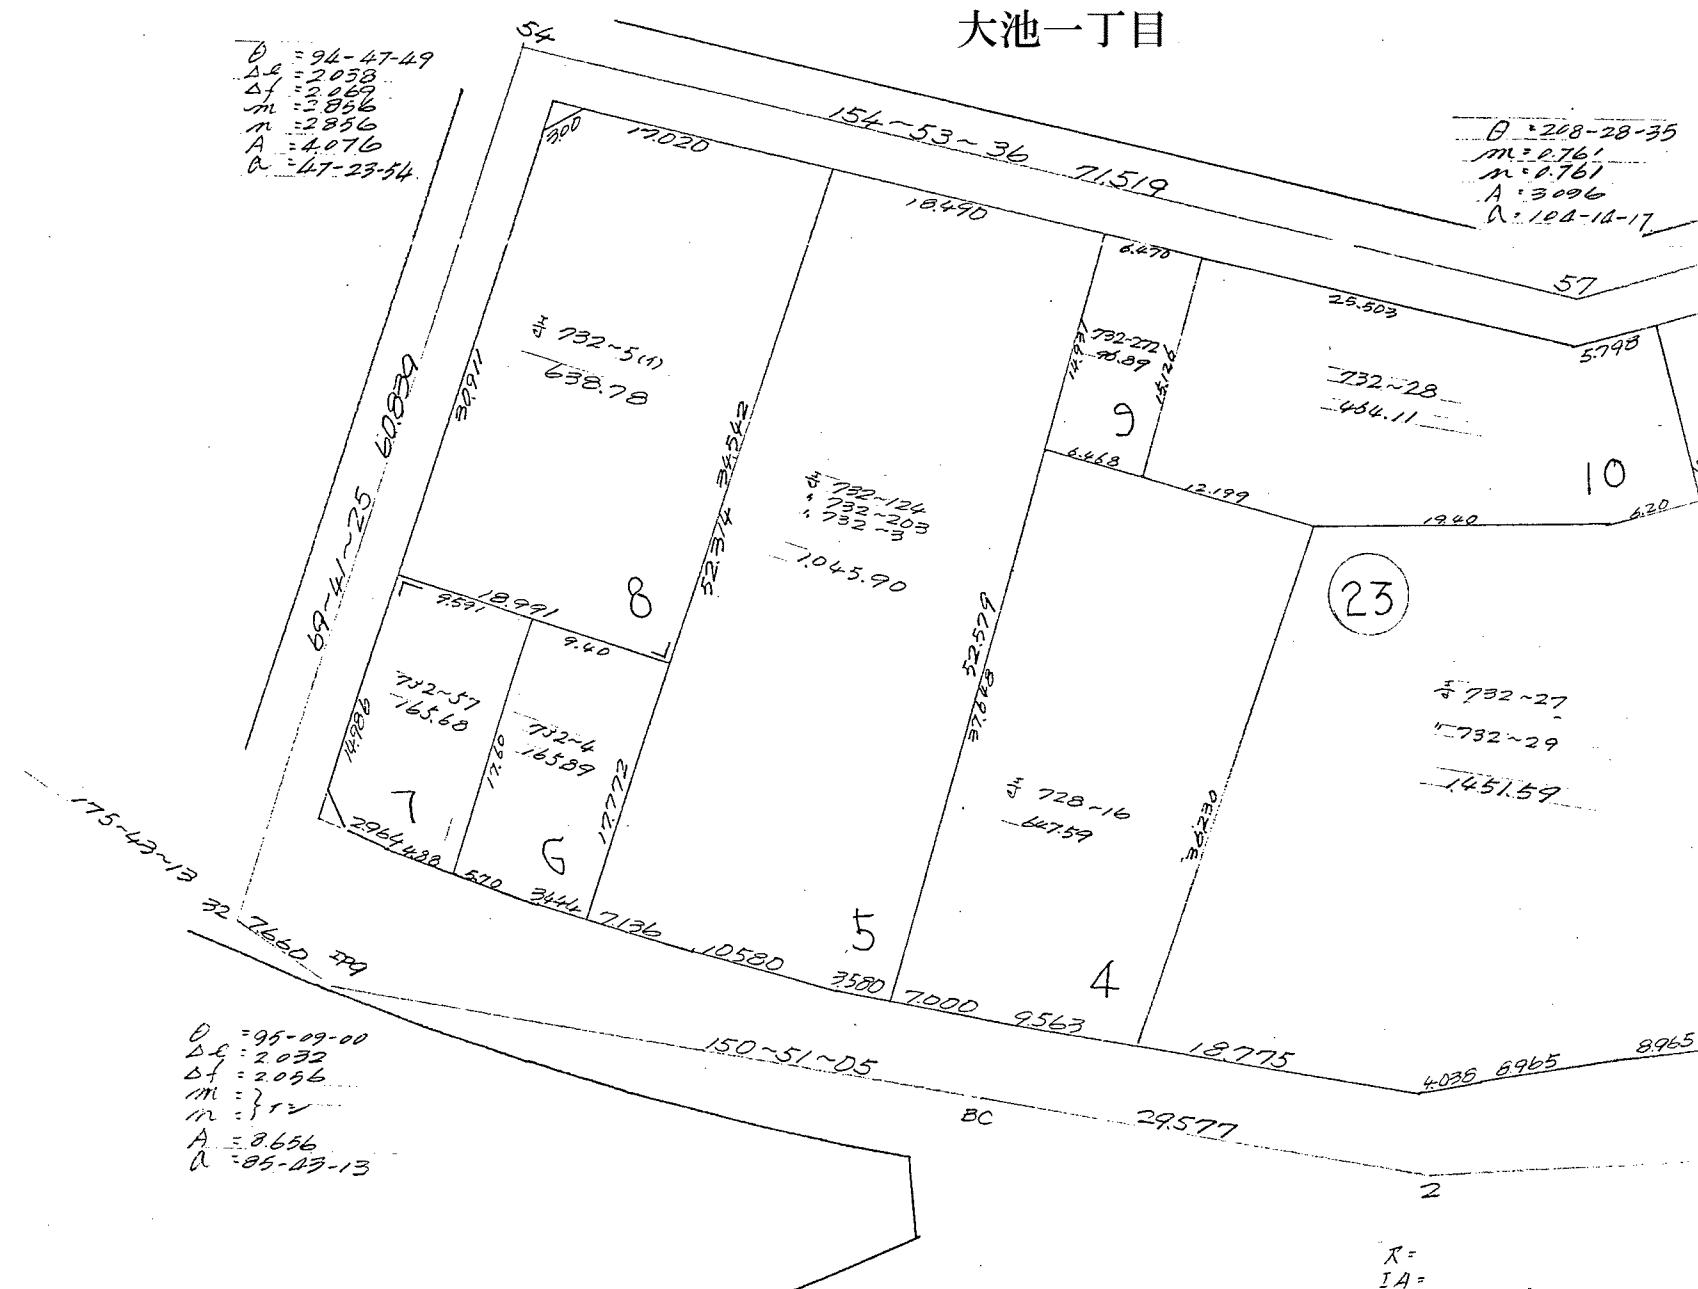

$$\begin{aligned}R &= \\IA &= \\TL &= \\SL &= \\CL &= \\A &= 11075\end{aligned}$$