




大池一丁目

$$\begin{aligned}\Delta e &= 1.958 \\ \Delta f &= 1.889 \\ m &= 3.534 \\ n &= 2.343 \\ b &= 4.635 \\ c &= 77.58 - 13 \\ a &= 40 - 9 - 43\end{aligned}$$

现状测量
0-253-54-00

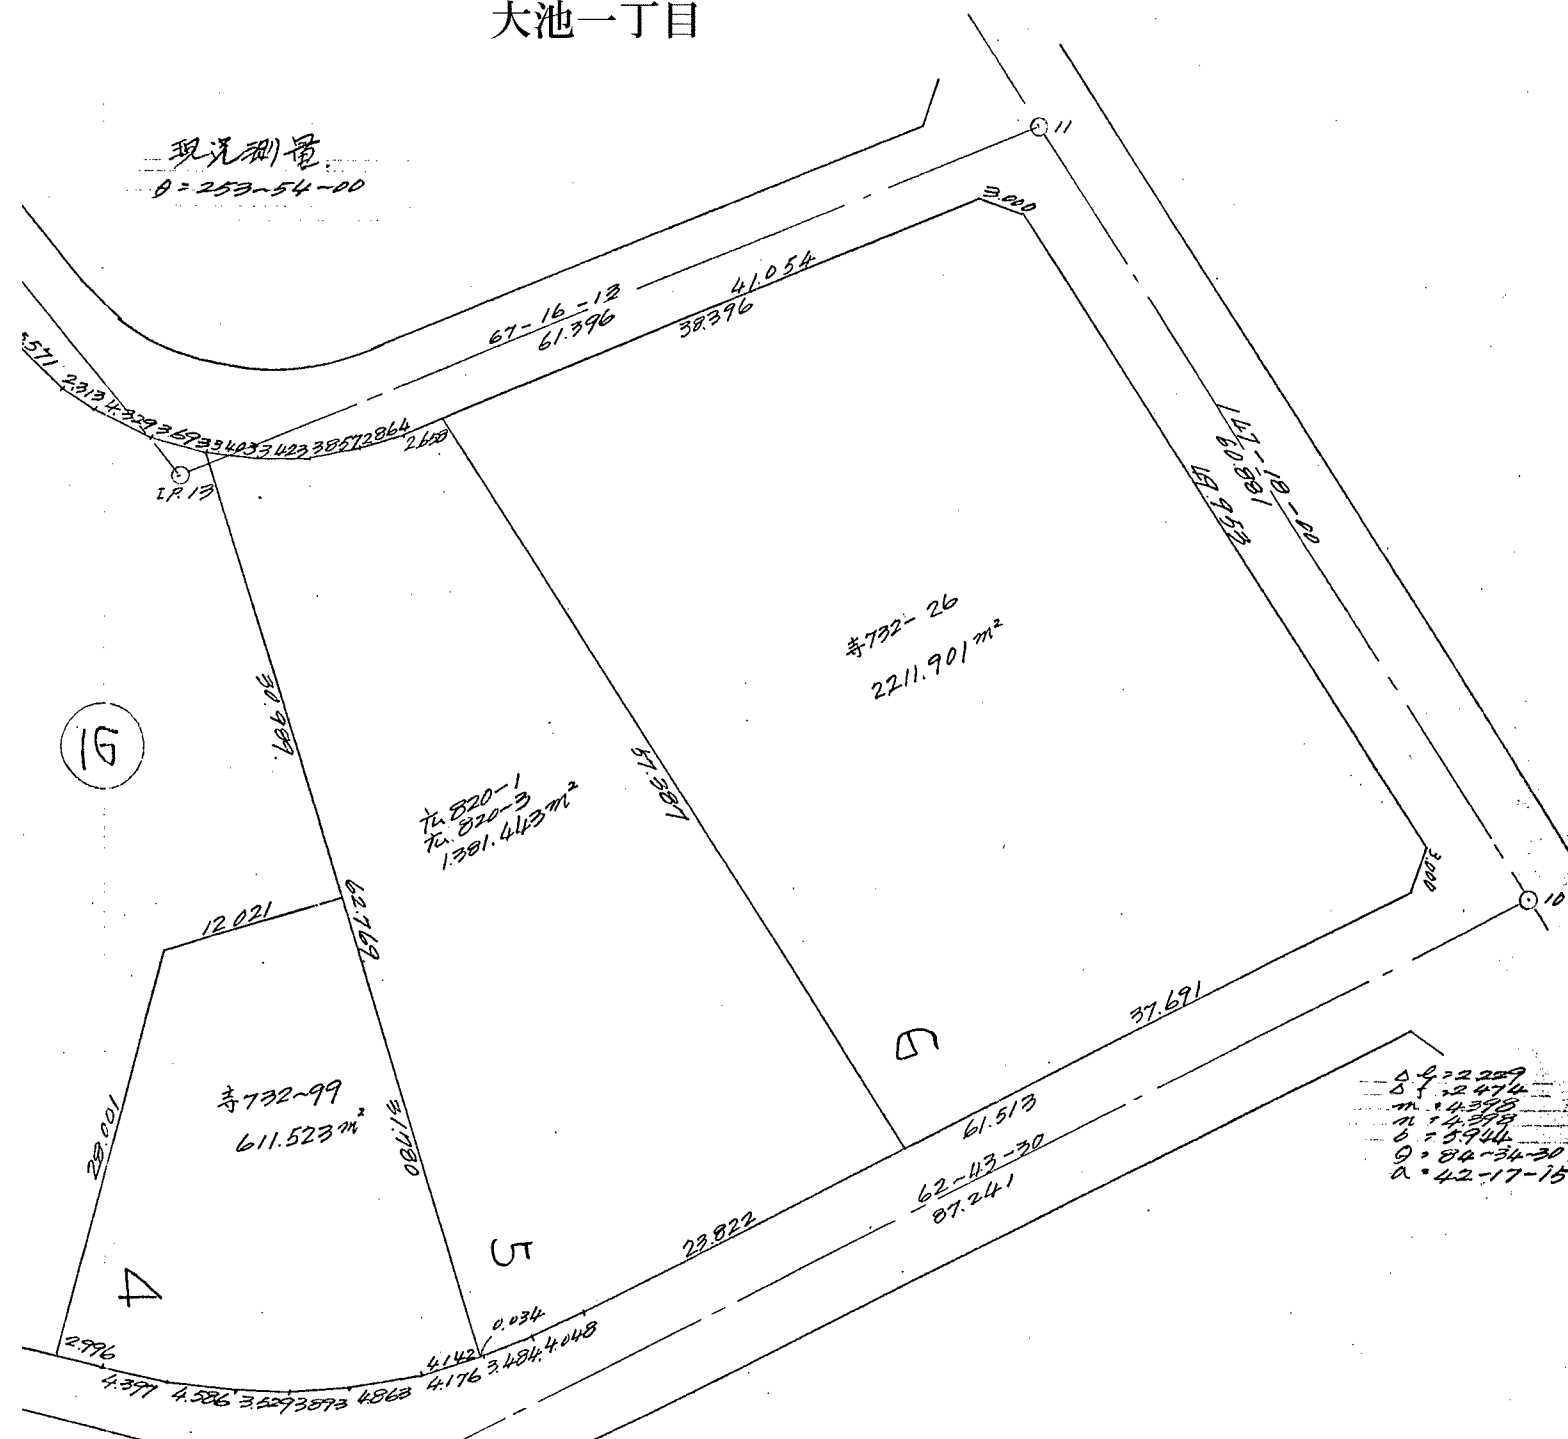

$\delta c = 2.229$
 $\delta f = 2.474$
 $m = 4.398$
 $n = 4.398$
 $o = 5.944$
 $q = 84-34-30$
 $a = 42-17-15$