


福岡市若久二丁目土地区画整理事業
基準点網図 縮尺 1/2,500

3級出来形確認測量基準点		
点名	X	Y
10D31	61529.747	-54209.613
3-0037	61456.221	-54502.081

4級出来形確認測量基準点		
点名	X	Y
4G-1	61794.963	-54342.180
4A-1	61746.804	-54358.162
4A-2	61726.617	-54349.393
4A-3	61672.290	-54309.860
4A-4	61626.254	-54315.759
4A-5	61596.545	-54345.863
4A-6	61567.984	-54344.428
4A-7	61540.093	-54373.451
4A-8	61511.899	-54414.461
4A-9	61532.697	-54350.295
4A-9-1	61550.774	-54357.482
4A-10	61615.506	-54302.469
4A-11	61591.094	-54307.131
4A-12	61553.473	-54317.065
4A-13	61523.966	-54330.414
4A-14	61502.755	-54333.347
4A-15	61497.630	-54370.103
4A-16	61489.419	-54392.930
4A-17	61468.963	-54427.897
4A-17-1	61471.336	-54444.227
4A-18	61443.879	-54458.411
4A-19	61458.857	-54485.040
4A-20	61591.763	-54268.010
4A-21	61549.532	-54242.258
節-1	61687.046	-54337.801

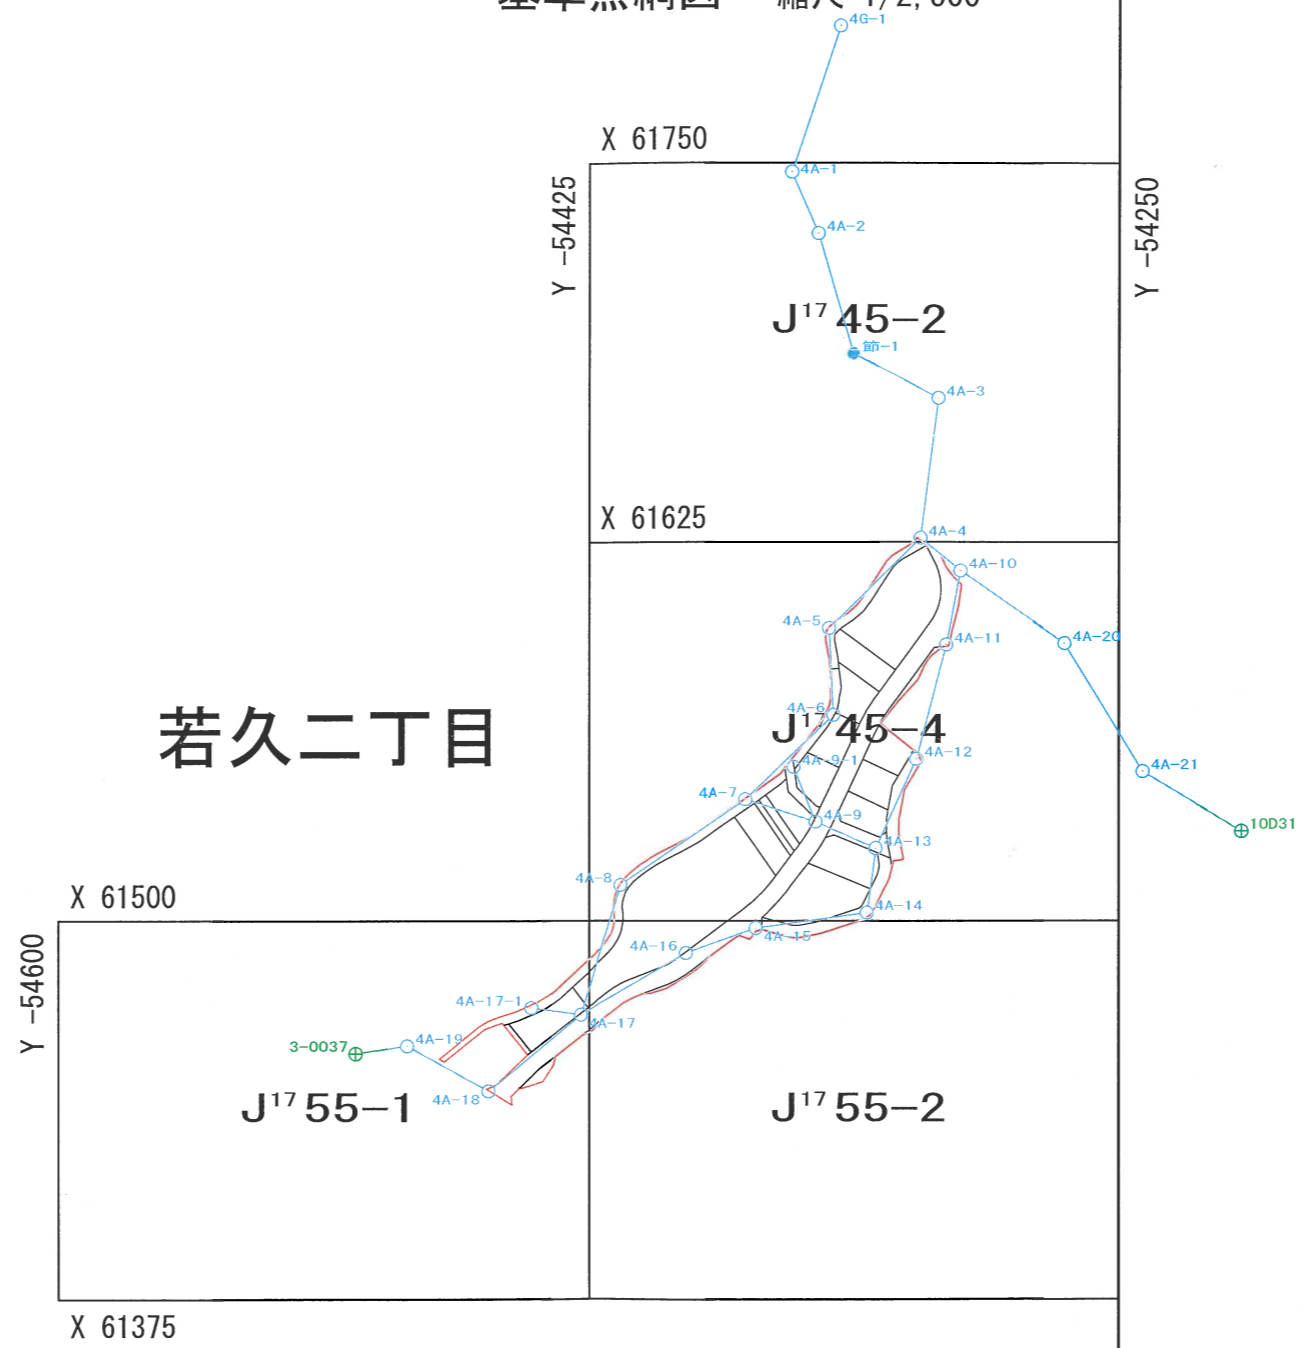

X 61250
J¹⁷ K¹⁷
W¹⁷ Z¹⁷

凡 例	
⊕	3級基準点
○	4級基準点
●	節点
▭	施工区域