


大池一丁目

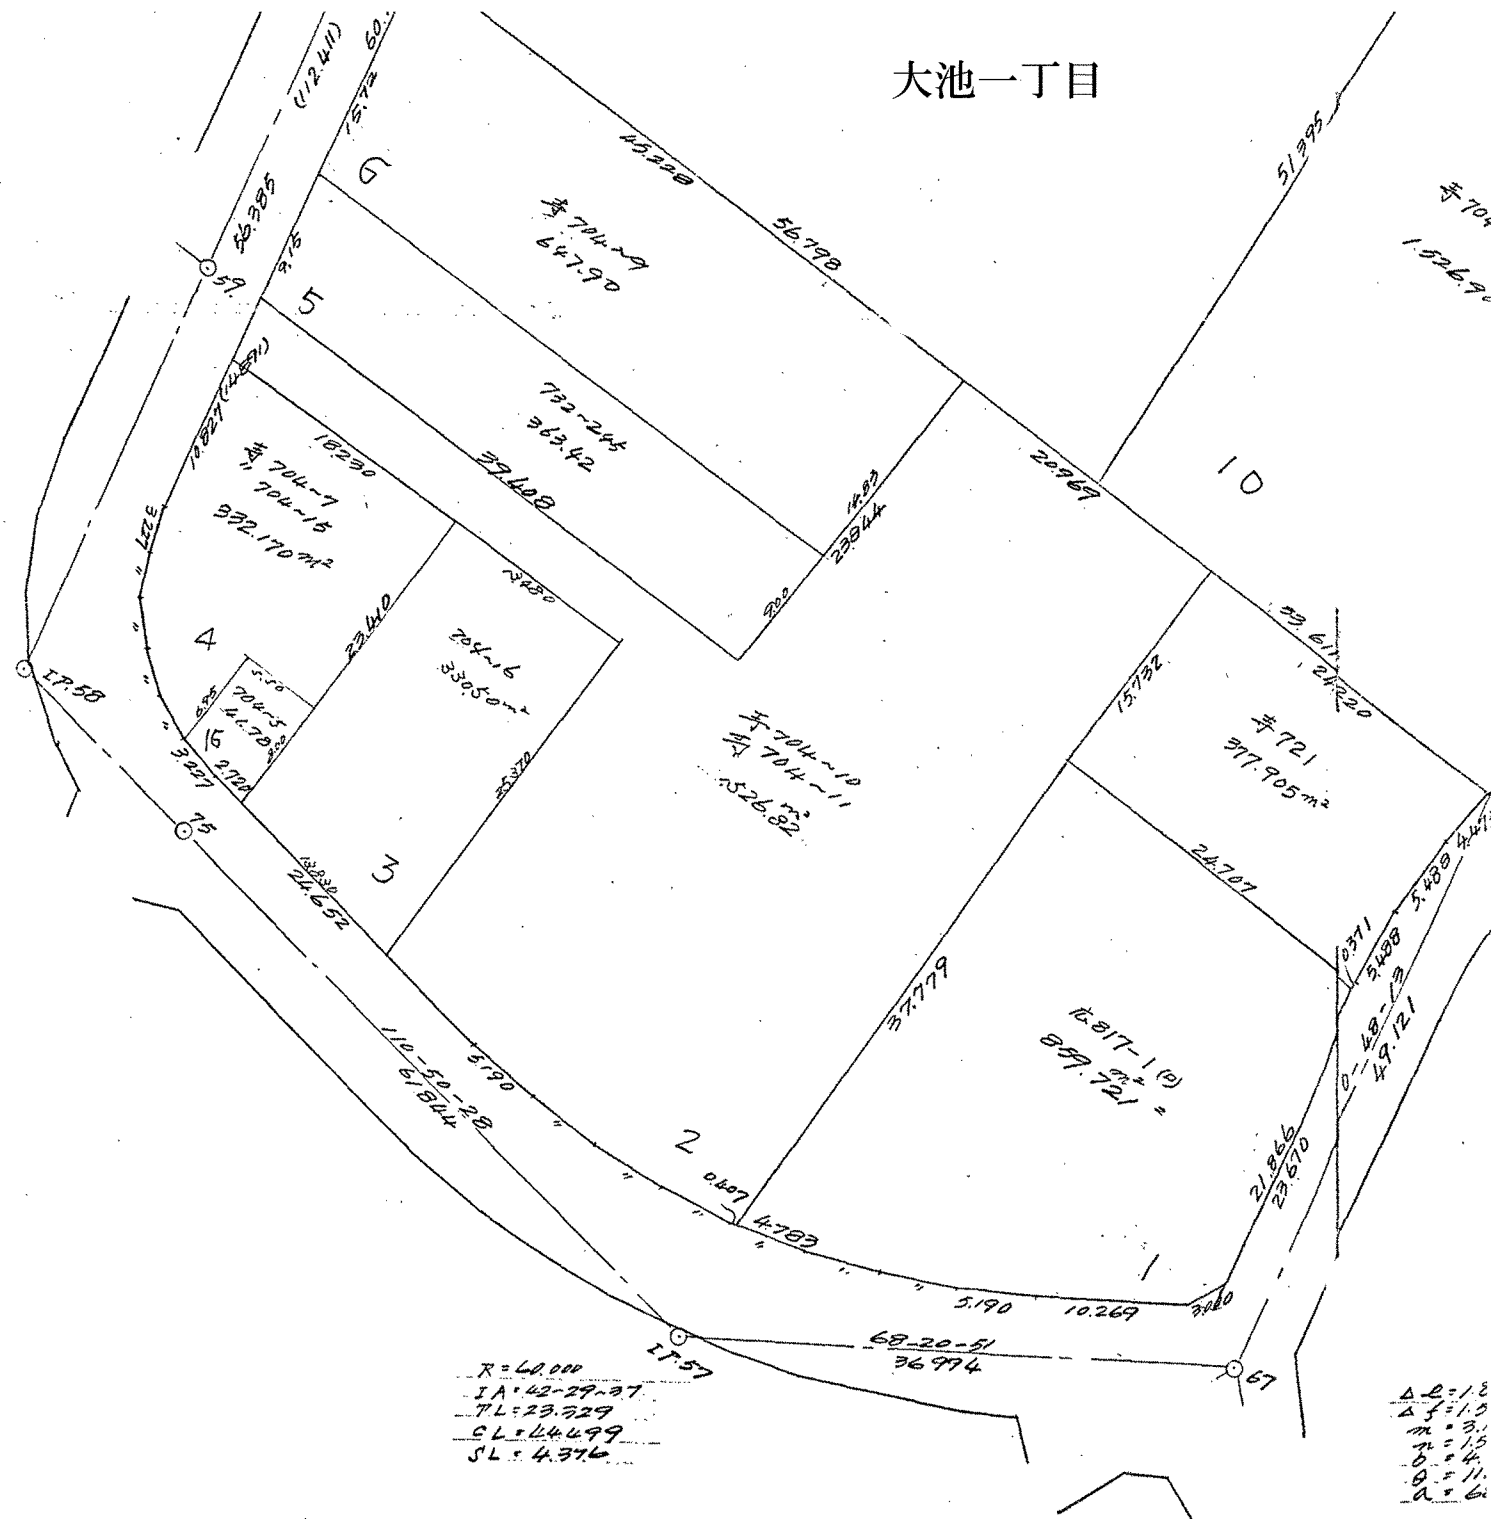

$X = 60,000$
 $IA = 42,29.37$
 $TL = 23,329$
 $CL = 44,499$
 $SL = 4,376$

$$\begin{aligned}\Delta L &= 1.8 \\ \Delta f &= 1.5 \\ m &= 3.1 \\ n &= 1.5 \\ b &= 4. \\ \theta &= 11. \\ a &= 6.\end{aligned}$$