


9

新

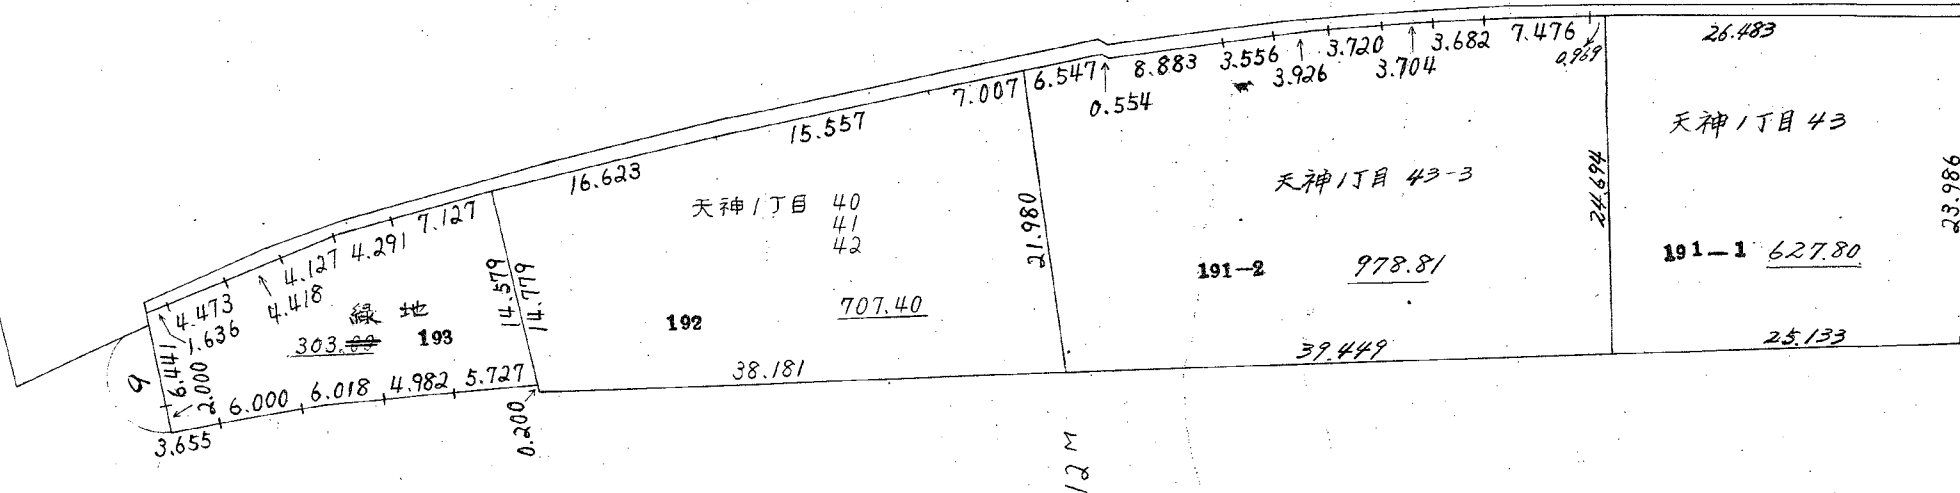

25 M